
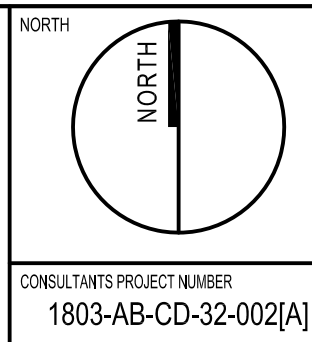


| AMENDMENTS |          |                  |     |
|------------|----------|------------------|-----|
| REV        | DATE     | AMENDMENT        | BY  |
| A          | 28.10.10 | AS - BUILT ISSUE | JMM |
|            |          |                  |     |
|            |          |                  |     |
AS - BUILT

CONSULTANTS DISCIPLINE

CONTRACT MANAGER

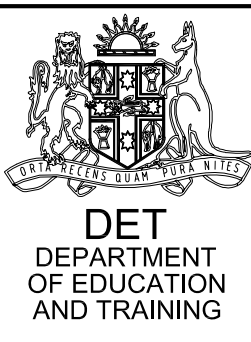

BUILDING EDUCATION REVOLUTION  
DURRUMBUL PUBLIC SCHOOL,  
DURRUMBUL ROAD, MAIN ARM

PROPOSED MDR / ADMIN LIBRARY  
CIVIL WORKS PLAN

| 0 1 2 3 4 5          |                 |                 |               |          | 1 : 100 |
|----------------------|-----------------|-----------------|---------------|----------|---------|
| SCALES (A1 Original) |                 | DRAFTED         | DATE          | 10/10    |         |
| 1 : 100              |                 | J.M.M.          |               | 10/10    |         |
| DRAWING NUMBER       | DISCIPLINE CODE | BUILDING NUMBER | SERIES NUMBER | REVISION |         |
| 1803                 | AB-CD           | 32              | 002           | A        |         |